


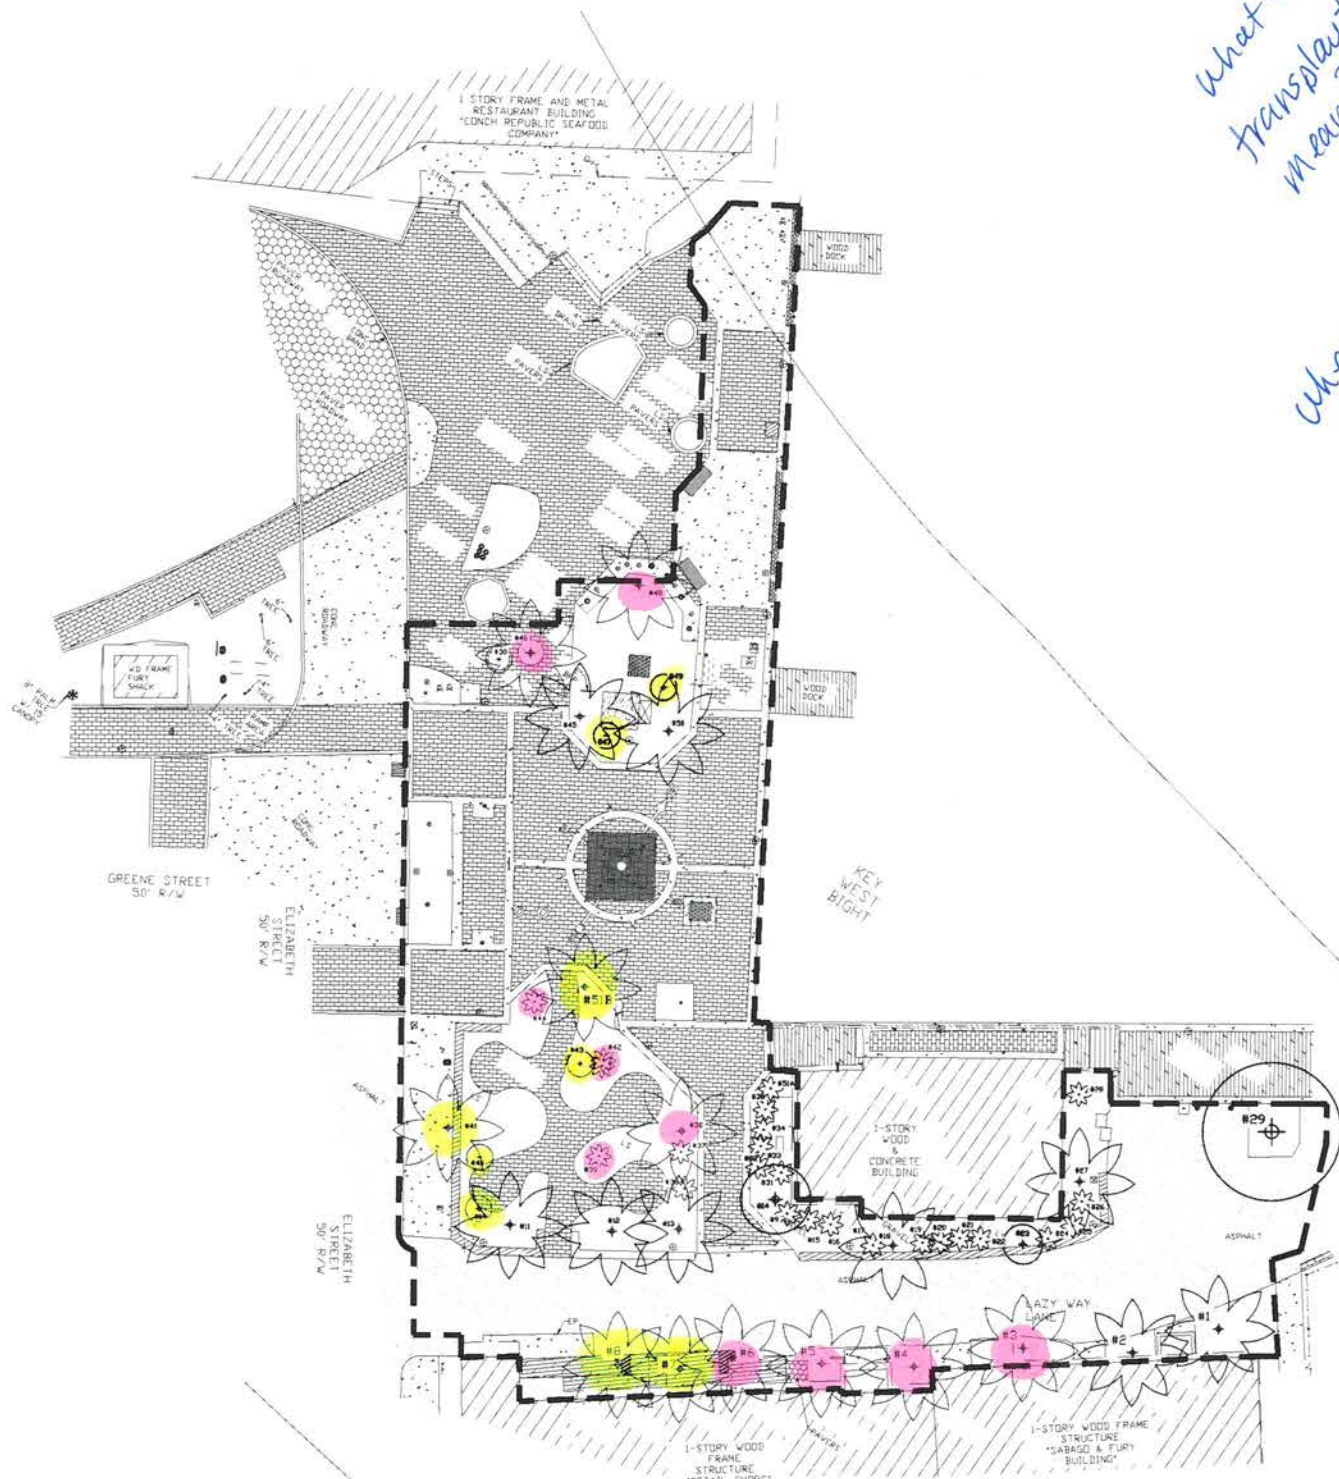

What does
transplant/Remove
mean? pick one
(clarify)
Where are transplants going?

NUMBER	BOTANICAL NAME	COMMON NAME	HEIGHT	SPREAD	CALIPER	CONDITION	STATUS
1	Cocos nucifera	Coconut Palm	30'-35'	20'	8'-12"	Fair	Remain
2	Cocos nucifera	Coconut Palm	30'-35'	20'	8'-12"	Fair	Remain
3	Cocos nucifera	Coconut Palm	30'-35'	20'	8'-12"	Fair	Transplant/Remove
4	Cocos nucifera	Coconut Palm	30'-35'	20'	8'-12"	Fair	Transplant/Remove
5	Cocos nucifera	Coconut Palm	30'-35'	20'	8'-12"	Fair	Transplant/Remove
6	Cocos nucifera	Coconut Palm	30'-35'	20'	8'-12"	Fair	Transplant/Remove
7	Cocos nucifera	Coconut Palm	30'-35'	20'	8'-12"	Fair/Adv. Roots	Remove
8	Cocos nucifera	Coconut Palm	30'-35'	20'	8'-12"	Fair/Adv. Roots	Remove
9	Thrinax radiata	Thatch Palm	3'	8'	4'-6" (2)	Fair	Remain
10	Cordia sebestena	Orange Geiger	6'-12'	6'-12'	3'-4"	Poor	Remove
11	Cocos nucifera	Coconut Palm	30'-35'	20'	8'-12"	Fair/Adv. Roots	Remain
12	Cocos nucifera	Coconut Palm	30'-35'	20'	8'-12"	Fair/Scarring	Remain
13	Cocos nucifera	Coconut Palm	30'-35'	20'	8'-12"	Good	Remain
14	Delonix regia	Poinciana	20'-25'	15'-20'	12"	Fair	Remain
15	Thrinax radiata	Thatch Palm	3'	8'	4'-6"	Fair	Remain
16	Thrinax radiata	Thatch Palm	8'-10'	8'	4'-6"	Fair	Remain
17	Thrinax radiata	Thatch Palm	8'-10'	8'	4'-6" (3)	Fair	Remain
18	Cocos nucifera	Coconut Palm	30'-35'	20'	8'-12"	Fair	Remain
19	Thrinax radiata	Thatch Palm	6'-8'	8'	4'-6"	Fair	Remain
20	Thrinax radiata	Thatch Palm	3'-4'	8'	4'-6" (3)	Fair	Remain
21	Adonis amili	Christmas Palm	10'-12'	8'-10'	Double	Fair	Remain
22	Thrinax radiata	Thatch Palm	8'-10'	8'	4'-6"	Fair	Remain
23	Bursera simarouba	Gumbo Limbo	20'-25'	15'-20'	6'-10" (2)	Fair	Remain
24	Thrinax radiata	Thatch Palm	4'-5'	8'	4'-6" (2)	Fair	Remain
25	Thrinax radiata	Thatch Palm	4'-6'	8'	4'-6" Multi	Fair	Remain
26	Thrinax radiata	Thatch Palm	4'-8'	8'	4'-6" Multi	Fair	Remain
27	Cocos nucifera	Coconut Palm	30'-35'	20'	8'-12"	Fair	Remain
28	Thrinax radiata	Thatch Palm	8'-10'	8'	4'-6"	Fair	Remain
29	Bursera simarouba	Gumbo Limbo	20'-25'	15'-20'	16"	Fair	Remain
30	Not Applicable						
31	Thrinax radiata	Thatch Palm	2'-4'	8'	4'-6"	Fair	Remain
32	Thrinax radiata	Thatch Palm	12'-14'	8'	4'-6"	Fair	Remain
33	Thrinax radiata	Thatch Palm	2'-4'	8'	4'-6"	Fair	Remain
34	Thrinax radiata	Thatch Palm	12'-14'	8'	4'-6"	Fair	Remain
35	Thrinax radiata	Thatch Palm	3'-4'	8'	4'-6"	Fair	Remain
36	Thrinax radiata	Thatch Palm	8'-10'	8'	4'-6"	Fair	Transplant
37	Thrinax radiata	Thatch Palm	8'-10'	8'	4'-6"	Fair	Transplant
38	Cocos nucifera	Coconut Palm	30'-35'	20'	8'-12"	Fair	Transplant/Remove
39	Thrinax radiata	Thatch Palm	6'-8'	8'	4'-6" (2)	Fair	Transplant
40	Cordia sebestena	Orange Geiger	6'-12'	4'-8'	3'-4"	Poor	Remove
41	Cocos nucifera	Coconut Palm	30'-35'	20'	8'-12"	Fair	Transplant
42	Thrinax radiata	Thatch Palm	6'-14'	8'	4'-6" (2)	Fair	Transplant
43	Bursera simarouba	Gumbo Limbo	6'-10'	15'-20'	6'-8" (2)	Poor	Remove
44	Thrinax radiata	Thatch Palm	6'-8'	8'	4'-6" (2)	Fair	Transplant
45	Cocos nucifera	Coconut Palm	30'-35'	20'	8'-12"	Fair	Remain
46	Cocos nucifera	Coconut Palm	30'-35'	20'	8'-12"	Fair	Transplant/Remove
47	Cordia sebestena	Orange Geiger	6'-12'	6'-12'	3" (2)	Poor	Remove
48	Cocos nucifera	Coconut Palm	30'-35'	20'	8'-12"	Fair	Transplant/Remove
49	Cordia sebestena	Orange Geiger	6'-12'	6'-12'	3"	Poor	Remove
50	Cocos nucifera	Coconut Palm	30'-35'	20'	8'-12"	Fair	Remain
51A	Thrinax radiata	Thatch Palm	6'-8'	8'	4'-6"	Fair	Remain
51B	Cocos nucifera	Coconut Palm	30'-35'	20'	8'-12"	Fair/Adv. Roots	Remove

Remove
transplant
Sample in 5-1-18

LEGEND

EXISTING PALM

EXISTING TREE

PROJECT LIMIT LINE

HISTORIC SEAPORT HARBORWALK - EXISTING TREE DISPOSITION PLAN AREA #1 GREENE & LAZY WAY

SCALE: 1/16" = 1'-0"

KEY WEST HISTORIC SEAPORT
PHASE II
KEY WEST, FLORIDA

WILLIAM P. HORN
ARCHITECT, P.A.

915 EATON ST.
KEY WEST,
FLORIDA
33040

TEL (305) 296-5302
FAX (305) 296-1033

LICENSE NO.
AA 0003940

KEY WEST
HISTORIC
SEAPORT
PHASE II

KEY WEST BIGHT
KEY WEST, FL 33040

ELIZABETH
NEWLAND

LANDSCAPE
ARCHITECTURE, LLC

2525 Ponce de Leon
Blvd., Suite 300
Coral Gables, Florida 33134
(305) 461-6001
lnewland@jwllc.com

SEAL

THESE DRAWINGS MAY
NOT BE REPRODUCED
WITHOUT WRITTEN
AUTHORIZATION BY
WILLIAM P. HORN


DATE


12-19-17 PHASE 2 REVISED
04-10-18 TREE COMMISSION

REVISIONS

DRAWN BY
JW

PROJECT
NUMBER
1609

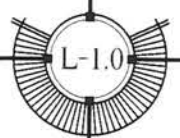

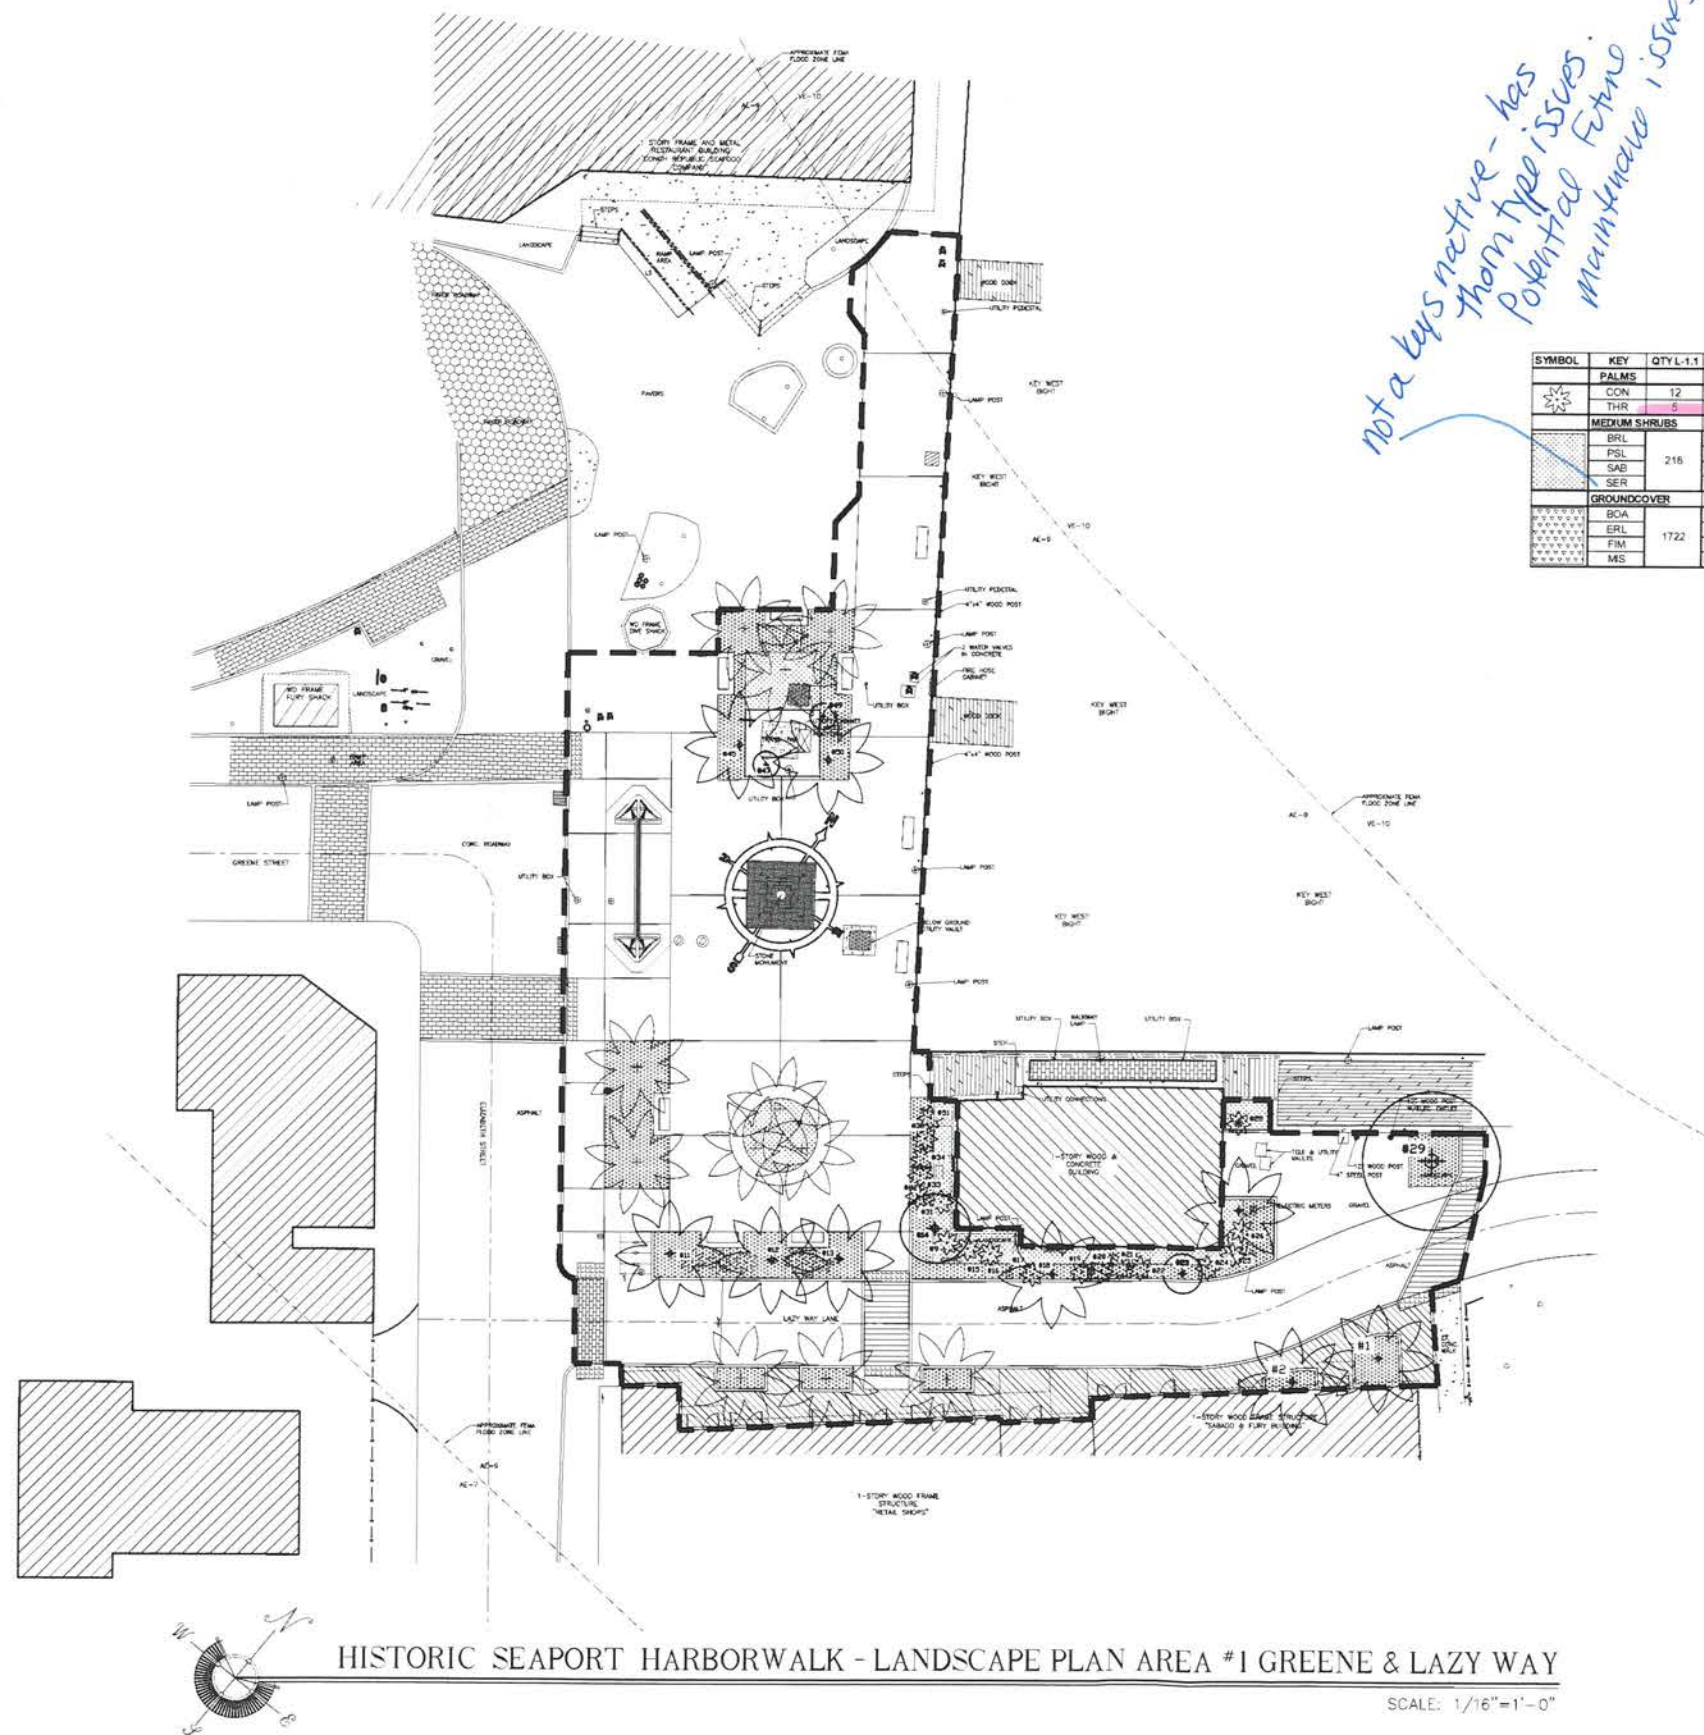

not a key native - has thorn type issues. Potential future maintenance issues.

please clarify - specifies on where and which ones.

SYMBOL	KEY	QTY L-1.1	SCIENTIFIC NAME	COMMON NAME	NATIVE	CALIPER	HEIGHT	CANOPY	CONTAINER	SPACING	CONDITION
PALMS	CON	12	Coccothrinax 'Green Malayan'	Green Malayan Coconut	No	10"-12"	14'-16' CT	15'-20'	B&B	As Shown	
	THR	5	Thrinax radiata	Thatch Palm	Yes	4'-6"	6'-8' CA	6'-8'	B&B	As Shown	Transplant From Site
MEDIUM SHRUBS	BRL	216	Brysonima lucida	Locust Berry	Yes	NA	24"-36"	24"-36"	7 Gal	24" OC	
	PSL		Psychotria ligustrifolia	Dwf. Wild Coffee	Yes	NA	18"-24"	18"-24"	7 Gal	24" OC	
	SAB		Savia bahamensis	Maiden Bush	Yes	NA	18"-24"	18"-24"	7 Gal	24" OC	
	SER		Serenoa repens	Saw Palmetto	Yes	NA	36"-48"	36"-48"	15 Gal	24" OC	Silver
GROUND COVER	BOA	1722	Bomarea tuberosa	Sea On-Eye Daisy	Yes	NA	12"-18"	12"-18"	1 Gal	12" OC	
	ERL		Ernestia littoralis	Golden Creeper	Yes	NA	12"-18"	12"-18"	1 Gal	12" OC	
	FIM		Ficus microcarpa 'Green Island'	Green Island Ficus	No	NA	12"-18"	12"-18"	3 Gal	12" OC	
	MS		Microsorium scolopendrium	Wart Fern	No	NA	12"-18"	12"-18"	1 Gal	12" OC	

WILLIAM P. HORN
ARCHITECT, P.A.

915 EATON ST.
KEY WEST,
FLORIDA
33040

TEL: (305) 296-8302
FAX: (305) 296-1033

LICENSE NO.
AA 6003040

KEY WEST
HISTORIC
SEAPORT
PHASE II

KEY WEST BIGHT
KEY WEST, FL 33940

ELIZABETH
NEWLAND
LANDSCAPE
ARCHITECTURE, LLC

2525 Ponce de Leon
Bldg., Suite 300
Coral Gables, Florida 33134
305-461-6301
lnewland@bellsouth.net

SEAL

THESE DRAWINGS MAY
NOT BE REPRODUCED
WITHOUT WRITTEN
AUTHORIZATION BY
WILLIAM P. HORN

DATE

12-19-17 PHASE 2 REVISED
04-10-18 TREE COMMISSION

REVISIONS


DRAWN BY
JW

PROJECT
NUMBER
1609

HISTORIC SEAPORT HARBORWALK - LANDSCAPE PLAN AREA #1 GREENE & LAZY WAY

SCALE: 1/16" = 1'-0"

KEY WEST HISTORIC SEAPORT
PHASE II
KEY WEST, FLORIDA

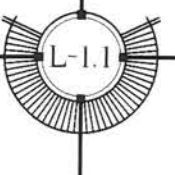

Existing Thatch palms +10ft+all

Recommend Transplanting (good condition) Why remove?

where transplant?

NUMBER	BOTANICAL NAME	COMMON NAME	HEIGHT	SPREAD	CALIPER	CONDITION	STATUS
52	Adonidia memli	Christmas Palm	15-20'	6-10'	Multi	Fair	Remove
53	Adonidia memli	Christmas Palm	15-20'	6-10'	Multi	Fair	Remove
54	Adonidia memli	Christmas Palm	15-20'	6-10'	Multi	Fair	Remove
55	Thrinax radiata	Thatch Palm	16-20'	8'	4"-6"	Fair	Remain
56	Thrinax radiata	Thatch Palm	16-20'	8'	4"-6"	Fair	Remain
57	Thrinax radiata	Thatch Palm	16-20'	8'	4"-6"	Fair	Remain
58 A	Swietenia mahagoni	Mahogany	20-30'	20-30'	24"	Good	Remain
58 B	Thrinax radiata	Thatch Palm	3'	6"	4"	Fair	Transplant
58 C	Thrinax radiata	Thatch Palm	3'	6"	4" (Multi)	Fair	Transplant
58 D	Thrinax radiata	Thatch Palm	3'	6"	4" (Multi)	Fair	Transplant

remove

transplant


Sam J. Lin 5-1-18

LEGEND

 EXISTING PALM

 EXISTING TREE

 PROJECT LIMIT LINE

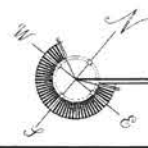

HISTORIC SEAPORT HARBORWALK - EXISTING TREE DISPOSITION PLAN - AREA #2 WILLIAM STREET PLAZA

SCALE: 1/16"=1'-0"

KEY WEST HISTORIC SEAPORT
PHASE II
KEY WEST, FLORIDA

WILLIAM P. HORN
ARCHITECT, P.A.

915 EATON ST.
KEY WEST,
FLORIDA
33040

TEL (305) 296-0302
FAX (305) 296-1633

LICENSE NO.
AA 0003040

KEY WEST HISTORIC
SEAPORT
PHASE II

KEY WEST BIGHT
KEY WEST, FL 33040

ELIZABETH
NEWLAND

LANDSCAPE
ARCHITECTURE, LLC

3525 Ponce de Leon
Blvd., Suite 300
Coral Gables, Florida 33134
305.461.6301
enewland@bellsouth.net

SEAL

THESE DRAWINGS MAY
NOT BE REPRODUCED
WITHOUT WRITTEN
AUTHORIZATION BY
WILLIAM P. HORN


DATE

12-19-17 PHASE 2 REVISED
04-10-18 TREE COMMISSION

REVISIONS


DRAWN BY
JW

PROJECT
NUMBER
1609

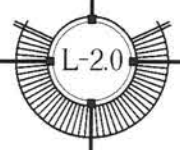

Existing
Thatch
Palms
+10ft+ tall

Yes!
area
needs
vegetative
enhancements

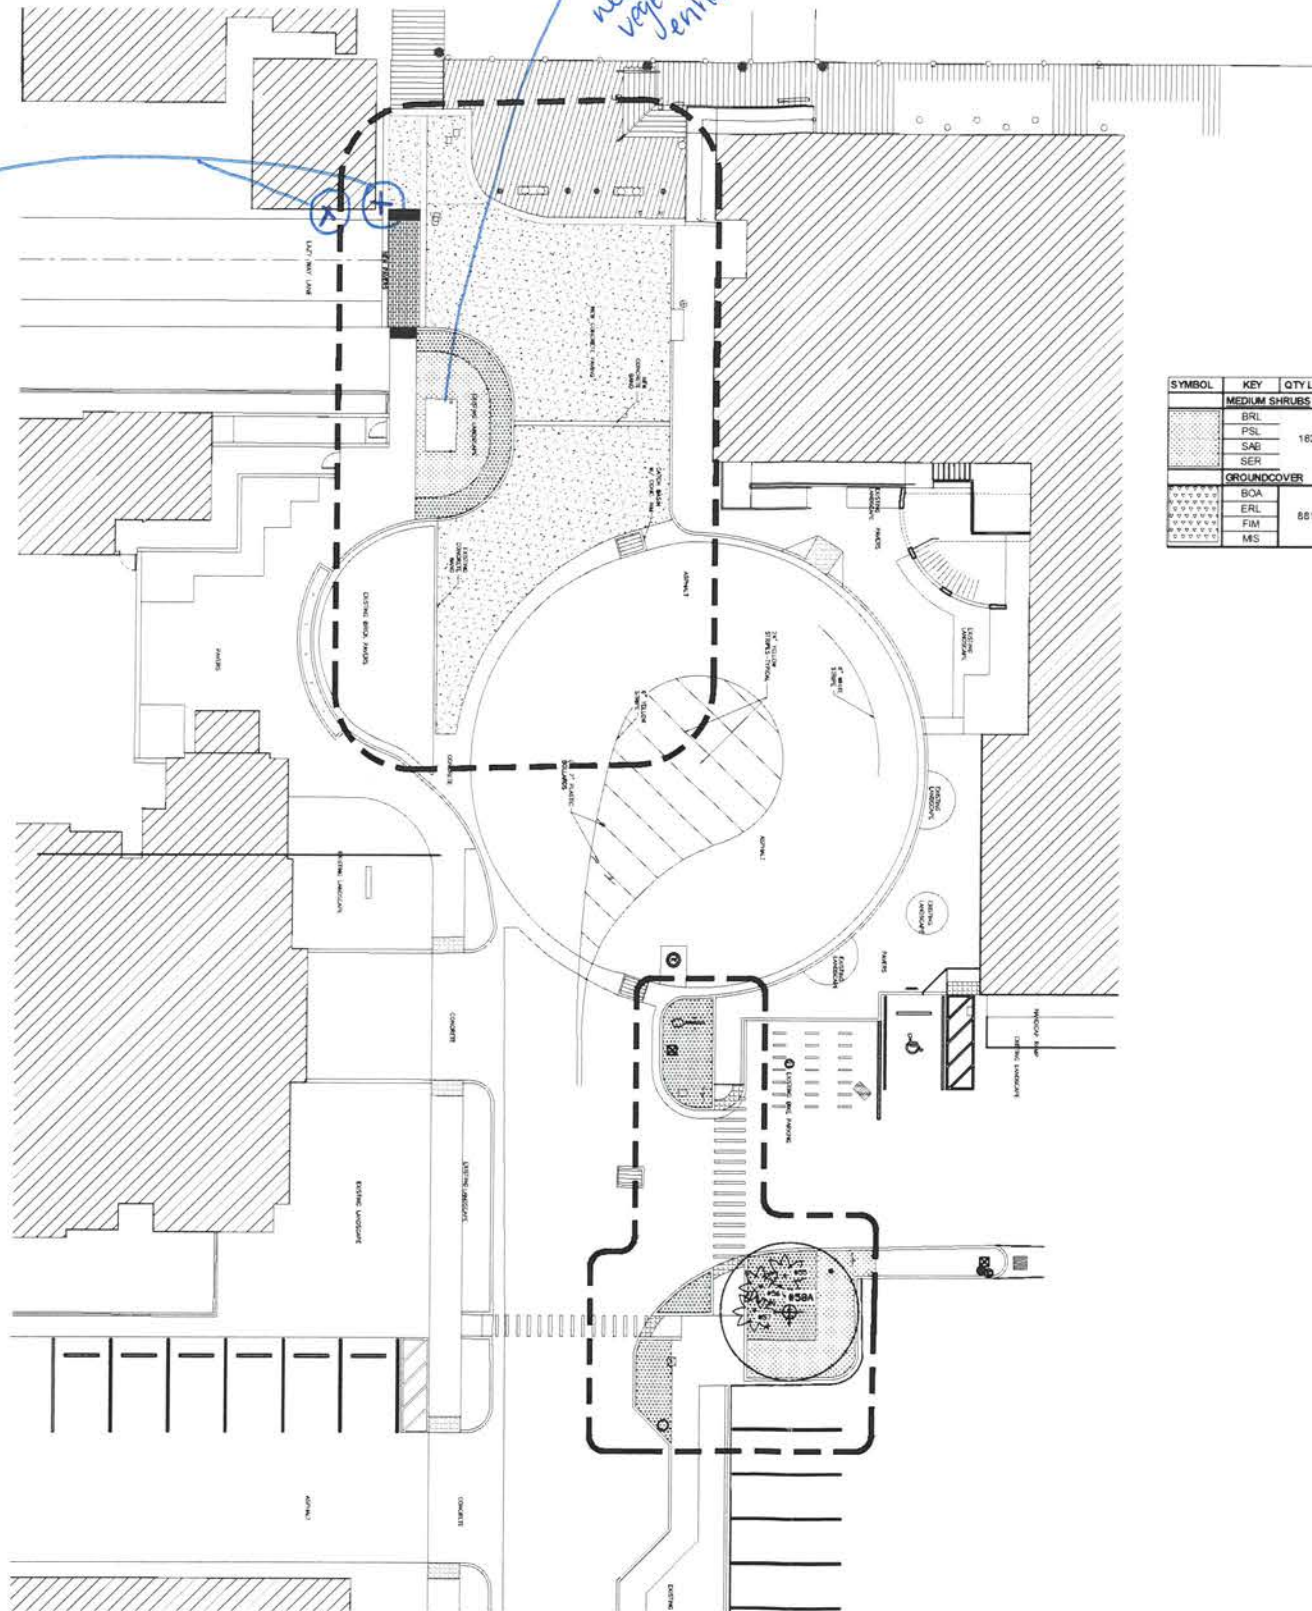

SYMBOL	KEY	QTY L-2.1	SCIENTIFIC NAME	COMMON NAME	NATIVE	CALIPER	HEIGHT	CANOPY	CONTAINER	SPACING	CONDITION
	MEDIUM SHRUBS										
	BRL	162	Brysonima lucida	Lorust Berry	Yes	NA	24'-36"	24'-36"	7 Gal	24" OC	
	PSL		Psychotria ligustrifolia	Dwarf Wild Coffee	Yes	NA	18'-24"	18'-24"	7 Gal	24" OC	
	SAB		Sava bahamensis	Maiden Bush	Yes	NA	18'-24"	18'-24"	7 Gal	24" OC	
	SER		Serenoa repens	Saw Palmetto	Yes	NA	36'-48"	36'-48"	15 Gal	24" OC	Silver
	GROUND COVER										
	BIOA	681	Borrichia frutescens	Sea Ox-Eye Daisy	Yes	NA	12'-18"	12'-18"	1 Gal	12" OC	
	ERL		Erodia littoralis	Golden Creeper	Yes	NA	12'-18"	12'-18"	1 Gal	12" OC	
	FIM		Ficus microcarpa 'Green Island'	Green Island Ficus	No	NA	12'-18"	12'-18"	3 Gal	12" OC	
	MS		Microsorium scolopendrium	Wart Fern	No	NA	12'-18"	12'-18"	1 Gal	12" OC	

Handwritten signature
5-2-18

WILLIAM P. HORN
ARCHITECT, P.A.

915 EATON ST.
KEY WEST,
FLORIDA
33040

TEL (305) 296-6262
FAX (305) 296-1033

LICENSE NO.
A.A. 0003040

KEY WEST
HISTORIC
SEAPORT
PHASE II

KEY WEST BIGHT
KEY WEST, FL. 33040

ELIZABETH
NEWLAND
LANDSCAPE
ARCHITECTURE, LLC

2525 Ponce de Leon
Blvd., Suite 300
Coral Gables, Florida 33134
305-481-6301
enewland@south.net

SEAL

THESE DRAWINGS MAY
NOT BE REPRODUCED
WITHOUT WRITTEN
AUTHORIZATION BY
WILLIAM P. HORN


DATE

12-19-17 PHASE 2 REVISED
04-10-18 TREE COMMISSION

REVISIONS

DRAWN BY
JW


PROJECT
NUMBER
1609

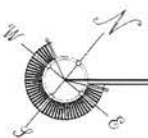


HISTORIC SEAPORT HARBORWALK - LANDSCAPE PLAN AREA #2 WILLIAM STREET PLAZA

SCALE: 1/16"=1'-0"

KEY WEST HISTORIC SEAPORT
PHASE II
KEY WEST, FLORIDA

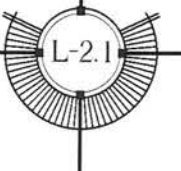

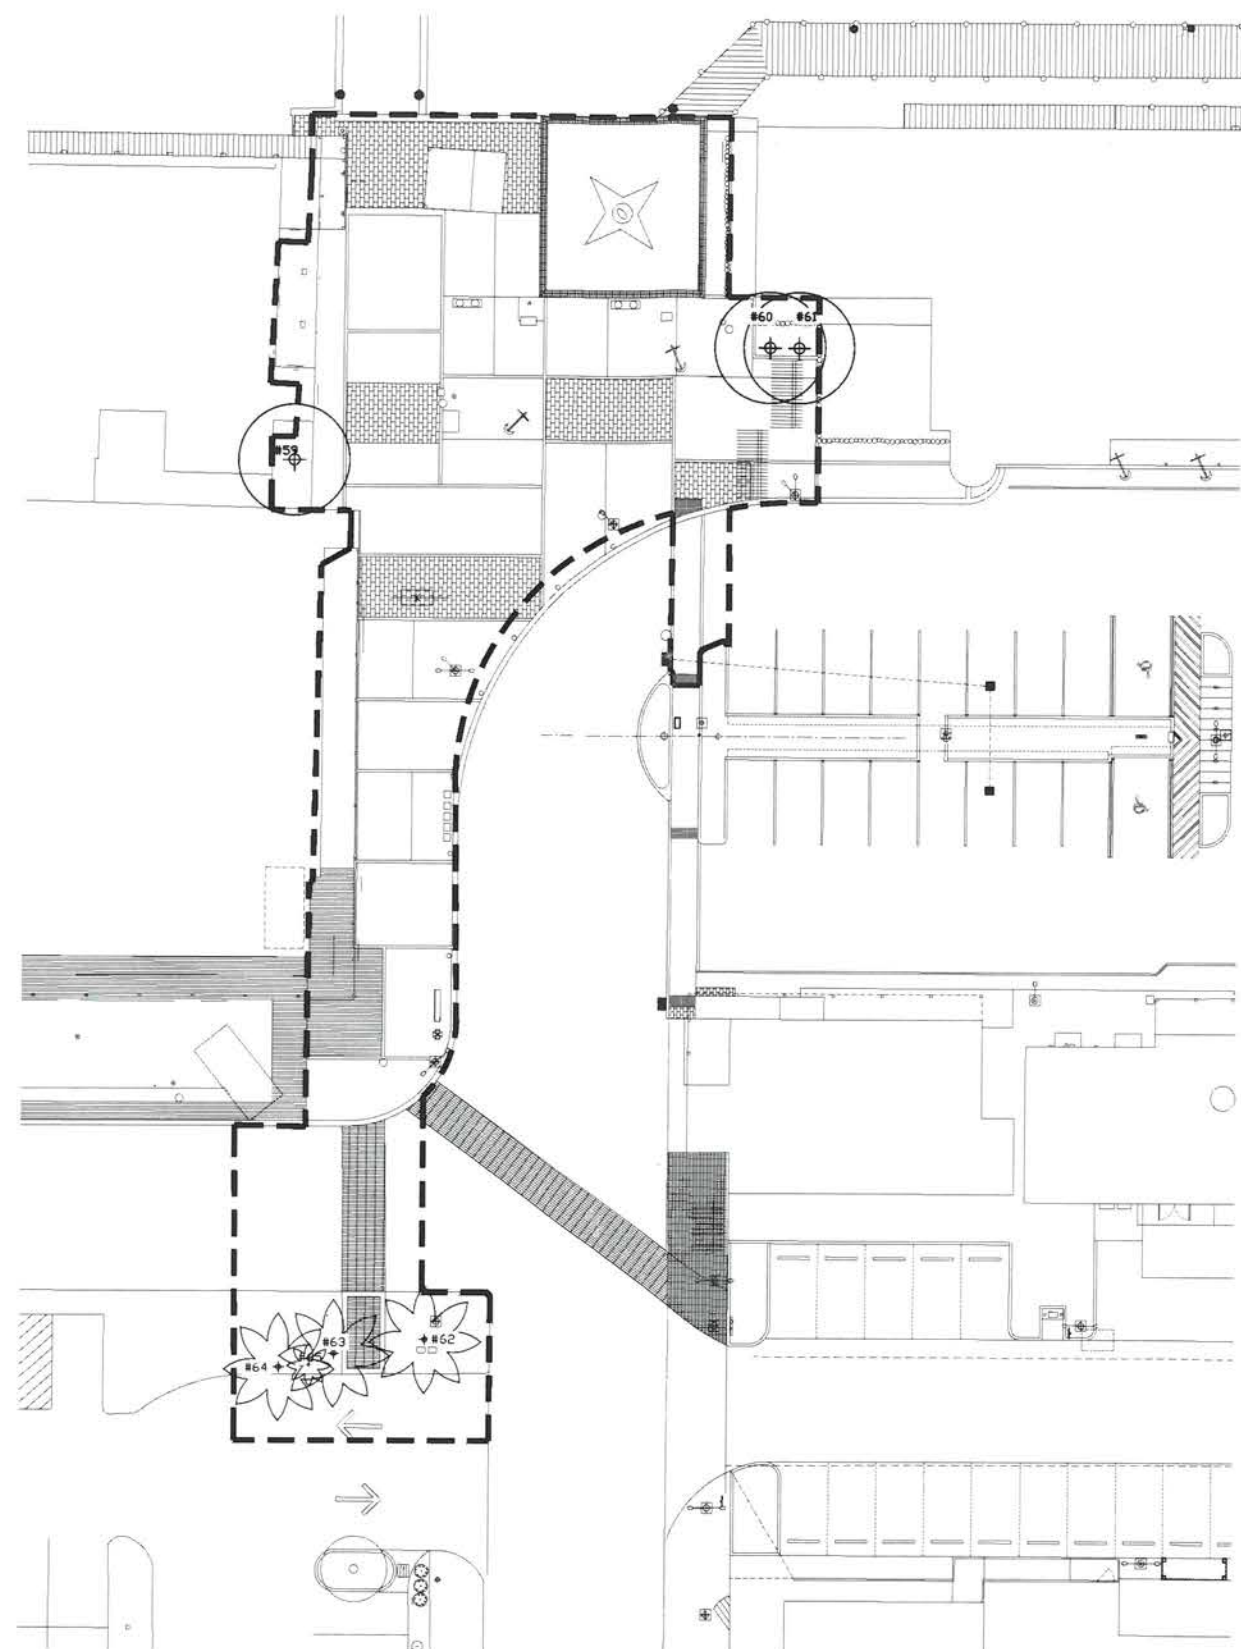

NUMBER	BOTANICAL NAME	COMMON NAME	HEIGHT	SPREAD	CALIPER	CONDITION	STATUS
59	Bursera simarouba	Gumbo Limbo	20'-22'	15'-20'	18" (2)	Fair	Remain
60	Bursera simarouba	Gumbo Limbo	15'-20'	15'-20'	Multi	Fair	Remain
61	Bursera simarouba	Gumbo Limbo	15'-20'	15'-20'	Multi	Fair	Remain
62	Cocos nucifera	Coconut Palm	30'-35'	20'	8"-12"	Fair	Remain
63	Cocos nucifera	Coconut Palm	30'-35'	20'	8"-12"	Fair	Remain
64	Cocos nucifera	Coconut Palm	30'-35'	20'	8"-12"	Fair	Remain
65	Sabal palmetto	Sabal Palm	15'-20'	6'	12"	Fair	Remain

remove
transplant


Kamplin
5-1-18

LEGEND

 EXISTING PALM

 EXISTING TREE

 PROJECT LIMIT LINE

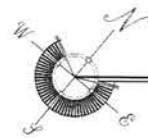

HISTORIC SEAPORT HARBORWALK - EXISTING TREE DISPOSITION PLAN - AREA #3 MARGARET STREET PLAZA

SCALE: 1/16" = 1'-0"

KEY WEST HISTORIC SEAPORT
PHASE II
KEY WEST, FLORIDA

WILLIAM P. HORN
ARCHITECT, P.A.

915 EATON ST.
KEY WEST,
FLORIDA
33040

TEL (305) 296-5302
FAX (305) 296-1033

LICENSE NO.
AA 0003940

KEY WEST HISTORIC
SEAPORT
PHASE II

KEY WEST RIGHT
KEY WEST, FL 33040

ELIZABETH
NEWLAND

LANDSCAPE
ARCHITECTURE, LLC

2525 Ponce de Leon
Bldg., Suite 300
Coral Gables, Florida 33134
305.481.6301
enewland@earthlink.net

SEAL

THESE DRAWINGS MAY
NOT BE REPRODUCED
WITHOUT WRITTEN
AUTHORIZATION BY
WILLIAM P. HORN


DATE


12-19-17 PHASE 2 REVISED
04-10-18 TREE COMMISSION

REVISIONS

DRAWN BY
JW

PROJECT
NUMBER
1609

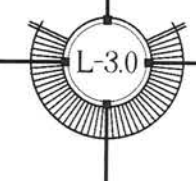

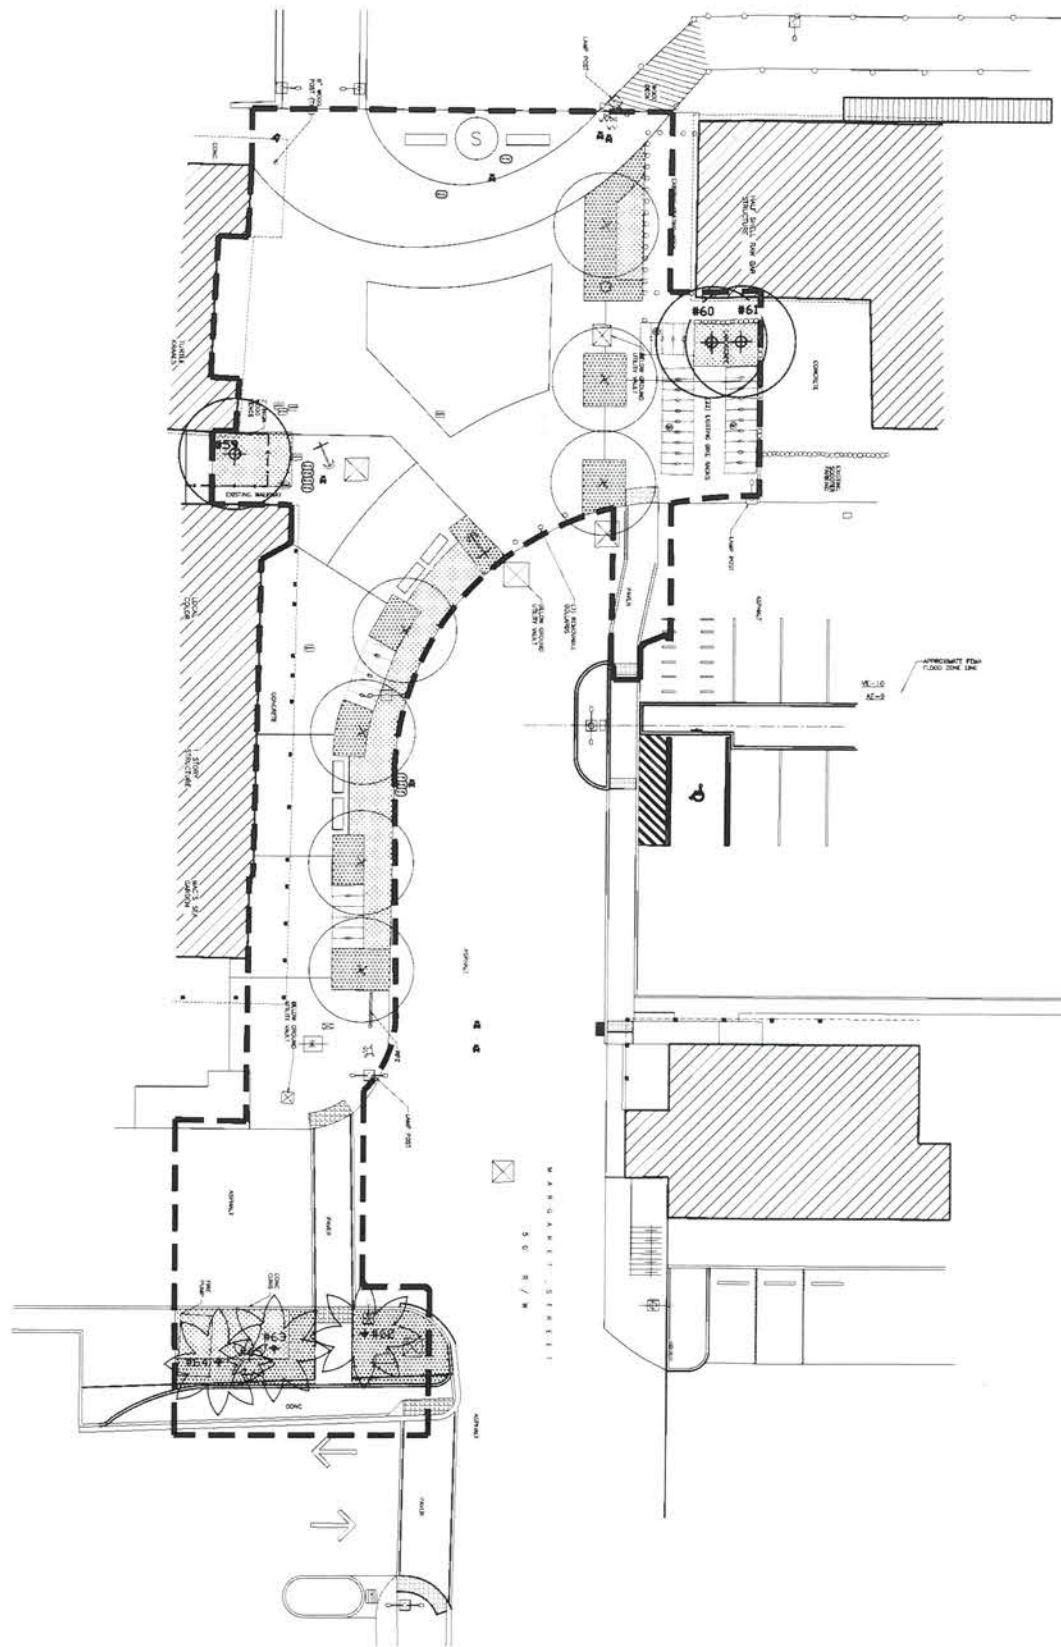


SYMBOL	KEY	QTY L-3.1	SCIENTIFIC NAME	COMMON NAME	NATIVE	CALIPER	HEIGHT	CANOPY	CONTAINER	SPACING	CONDITION
●	TREES										
	COO	7	Coccoloba diversifolia	Pigeon Plum	Yes	3"-4"	14'-16'	8'-10'	100 Gal	As Shown	5' CT
★	PALMS										
	CON		Coccothrinax 'Green Malayan'	Green Malayan Coconut	No	10"-12"	14'-16' CT	15'-20'	8&B	As Shown	
	THR		Thrinax radiata	Thatch Palm	Yes	4'-6"	6'-8' OA	6'-8'	8&B	As Shown	Transplant From Site
●	MEDIUM SHRUBS										
	BRL	302	Brysonima lucida	Locust Berry	Yes	NA	24'-36"	24'-36"	7 Gal	24" OC	
	PSL		Psychotria ligustrifolia	Dwarf Wild Coffee	Yes	NA	18"-24"	18"-24"	7 Gal	24" OC	
	SAB		Sarcia bahamensis	Maiden Bush	Yes	NA	18"-24"	18"-24"	7 Gal	24" OC	
	SER		Serenoa repens	Saw Palmetto	Yes	NA	36"-48"	36"-48"	15 Gal	24" OC	Silver
●	GROUND COVER										
	BOA		Borreria hillebrandii	Sea Ox-Eye Daisy	Yes	NA	12"-18"	12"-18"	1 Gal	12" OC	
	ERL	1660	Erhodia litoralis	Golden Creeper	Yes	NA	12"-18"	12"-18"	1 Gal	12" OC	
	FIM		Ficus microcarpa 'Green Island'	Green Island Ficus	No	NA	12"-18"	12"-18"	3 Gal	12" OC	
	MS		Microsorum scolopendrium	Wart Fern	No	NA	12"-18"	12"-18"	1 Gal	12" OC	

LEGEND

★ EXISTING PALM

● EXISTING TREE

--- PROJECT LIMIT LINE

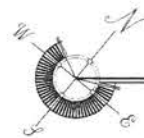

HISTORIC SEAPORT HARBORWALK - LANDSCAPE PLAN AREA #3 MARGARET STREET PLAZA

SCALE: 1/16"=1'-0"

KEY WEST HISTORIC SEAPORT
PHASE II
KEY WEST, FLORIDA



WILLIAM P. HORN
ARCHITECT, P.A.

915 EATON ST.
KEY WEST,
FLORIDA
33940

TEL (305) 296-5302
FAX (305) 296-1033

LICENSE NO.
AA 0003040

KEY WEST HISTORIC SEAPORT
PHASE II

KEY WEST RIGHT
KEY WEST, FL. 33940

ELIZABETH NEWLAND
LANDSCAPE ARCHITECTURE, LLC

2525 Ponce de Leon Blvd., Suite 300
Coral Gables, Florida 33134
305-481-6901
enewland@bellsouth.net

SEAL

THESE DRAWINGS MAY NOT BE REPRODUCED WITHOUT WRITTEN AUTHORIZATION BY WILLIAM P. HORN

DATE

12-19-17 PHASE 2 REVISED
04-10-18 TREE COMMISSION

REVISIONS

DRAWN BY
JW

PROJECT NUMBER
1609